THIS DRAWING IS UNPUBLISHED. RELEASED FOR PUBLICATION 2006
© COPYRIGHT 2006 BY TYCO ELECTRONICS CORPORATION. ALL RIGHTS RESERVED.

LOC	DIST
A1	-

REVISIONS

P	LTR	DESCRIPTION	DATE	DWN	APVD
	C	EGA0-1780-04	19AUG2004	TK	-
	C1	SEE E-06-021419	06SEP2006	LN	TK
	C2	SEE E-06-022752	25SEP2006	LN	VB
	C3	SEE E-10-003546	17FEB2010	SK	RH

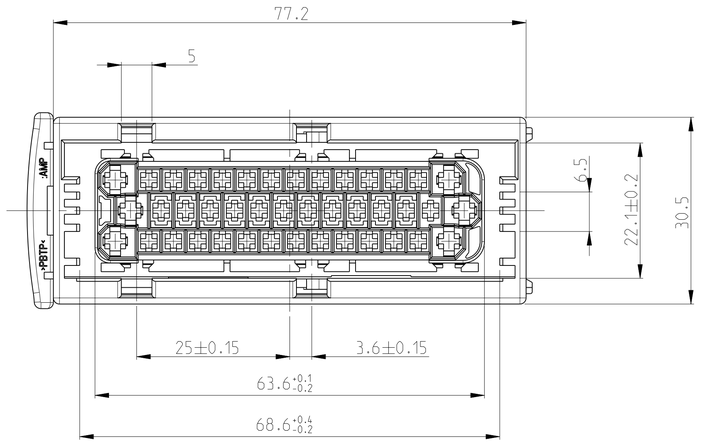

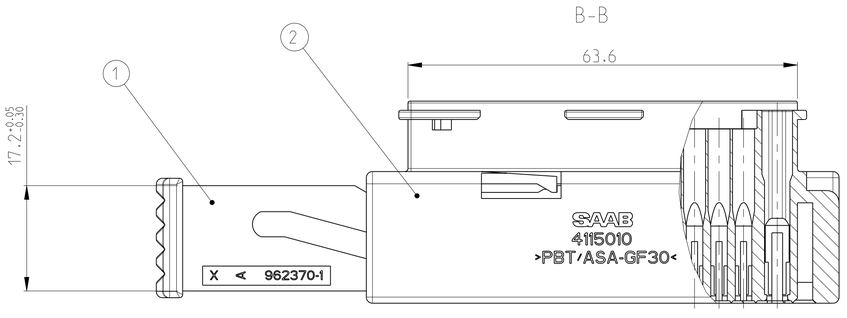

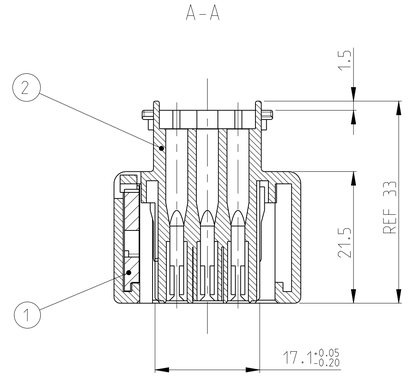

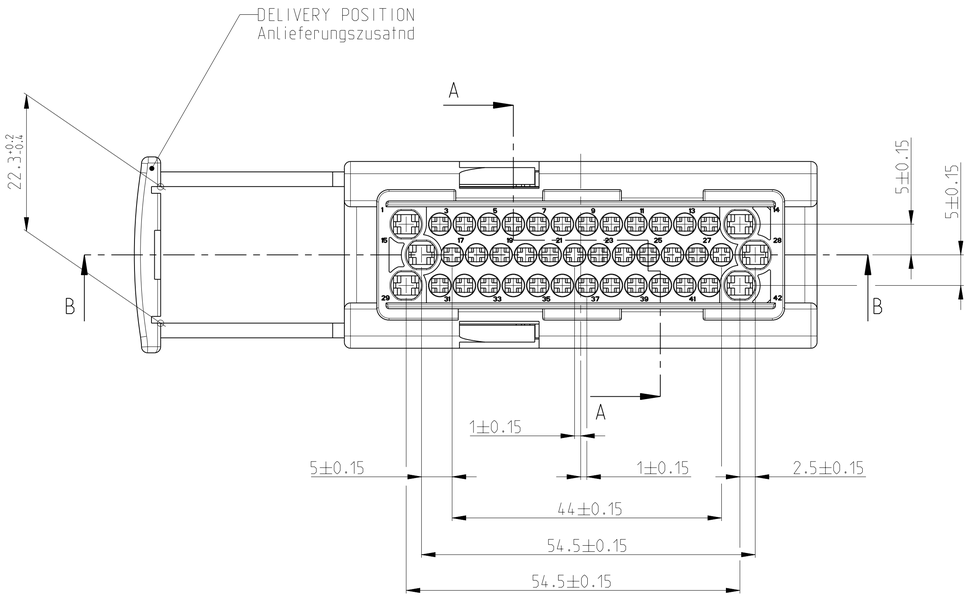

1 MATERIAL MARKING
Materialbezeichnung

1-...-1 2-...-1 5-...-1	>PBT/ASA-GF30<
~~3-...-1~~ ~~4-...-1~~	~~>PBT<~~

Kodierung A1

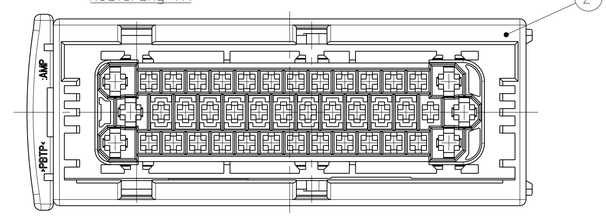

Kodierung B1

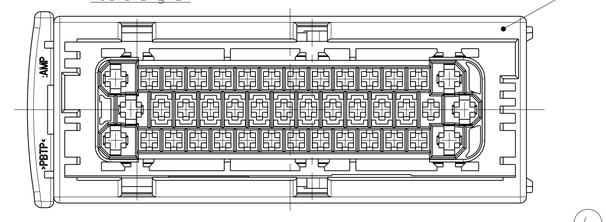

Kodierung C1

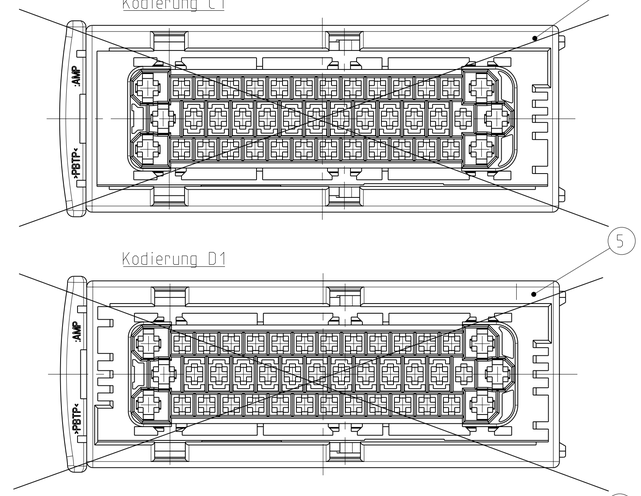

Kodierung D1

Kodierung N

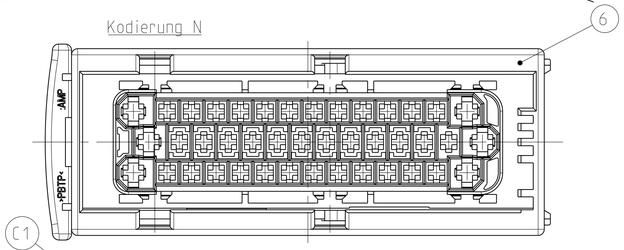

1-...-1 AS SHOWN
wie gezeichnet

C1

1					G	5-962369-1	42POS. REC. HSG. COD. N	PBT/ASA-GF30	WHITE	6
~~-~~					~~4~~	~~4-962369-1~~	~~42POS. REC. HSG. COD. D1~~	PBT/ASA-GF30	BROWN	5
		~~-~~			~~4~~	~~3-962369-1~~	~~42POS. REC. HSG. COD. C1~~	PBT/ASA-GF30	BLUE	4
			1		G	2-962369-1	42POS. REC. HSG. COD. B1	PBT/ASA-GF30	GREY	3
				1	G	1-962369-1	42POS. REC. HSG. COD. A1	PBT/ASA-GF30	BLACK	2
1	1	1	1	1	3	0-962370-1	SLIDE FOR 42POS. REC. HSG.	PBT-GF30	RED	1
				QTY	REV	PN	DESCRIPTION	MATERIAL	COLOUR	POS
C	-	-	C	C	ASSY REVISION					
5-...-1	4-...-1	3-...-1	2-...-1	1-...-1	ASSY ORDER					

C2

THIS DRAWING IS A CONTROLLED DOCUMENT OF TYCO ELECTRONICS CORPORATION IT IS SUBJECT TO CHANGE AND THE CONTROLLING ENGINEERING ORGANIZATION SHOULD BE CONTACTED FOR THE LATEST REVISION.

DIMENSIONS: mm

TOLERANCES UNLESS OTHERWISE SPECIFIED:
0 PLC ±0.5
1 PLC ±0.5
2 PLC ±0.5
3 PLC ±-
4 PLC ±-
ANGLES ±2°

MATERIAL see table -
FINISH - -

DWN L. Nguyen 20APR2006
CHK T. Kilian 06SEP2006
APVD -
PRODUCT SPEC -
APPLICATION SPEC -
WEIGHT -

Tyco Electronics
Tyco Electronics AMP GmbH
64625 Bensheim (Germany)

NAME 42POS. REC. HSG. MT2/JPT, ASS'Y
42pol. Mix Kontaktgehaeuse
MT2/JPT, Ass'y

SIZE A | CAGE CODE 00779 | DRAWING NO C-963226 | RESTRICTED TO -

CUSTOMER DRAWING | SCALE 2:1 | SHEET 1 OF 1 | REV C3